

***AS BUILT***

***DRAWINGS***

***s/n: 30138***

***A#: 671298***

***CRN: Y1927.213***


***96" od. x 30' s/s***

***Free Water Knockout***






The information contained in this drawing is the confidential property of Platinum Energy Services ULC. No part thereof shall be reproduced or communicated to a third party without written authorization from Platinum Energy Services ULC.

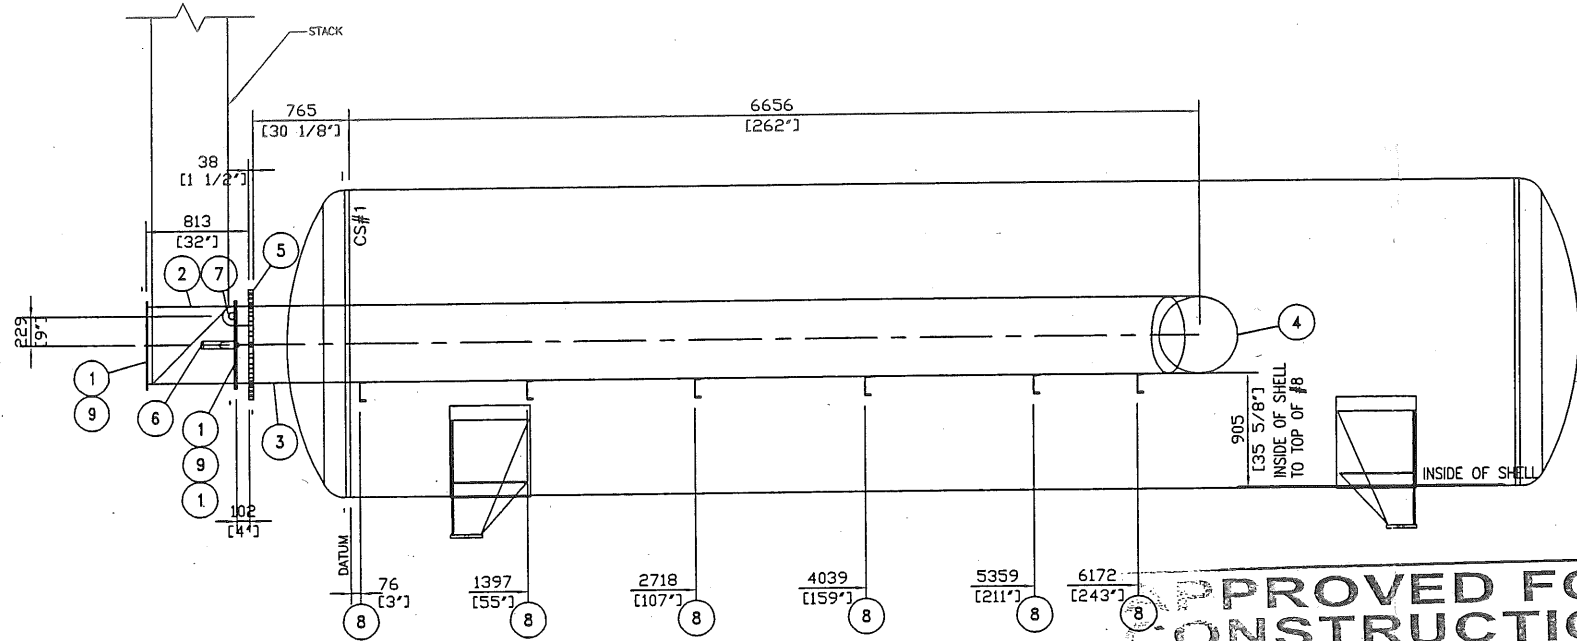


FIRETUBE ASSY. ELEVATION VIEW


APPROVED FOR  
CONSTRUCTION  
OCT 31 2017  
SIGNED: *[Signature]*  
REVISED  
DESTROY ALL PREVIOUS COPIES

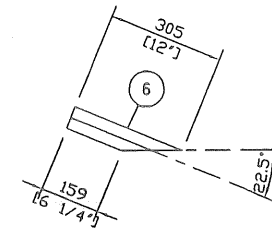


ITEM #6 DETAIL

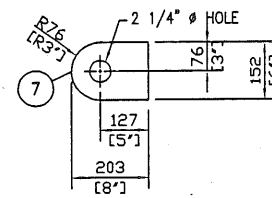

ITEM #7 DETAIL

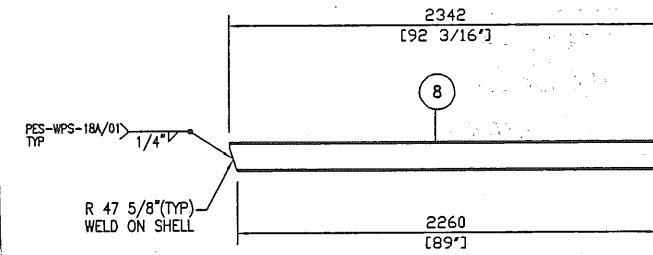


ITEM #8 DETAIL

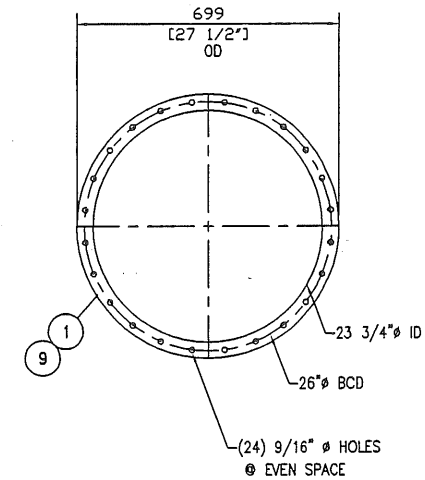


BURNER FLANGE & GASKET

QUALITY CONTROL

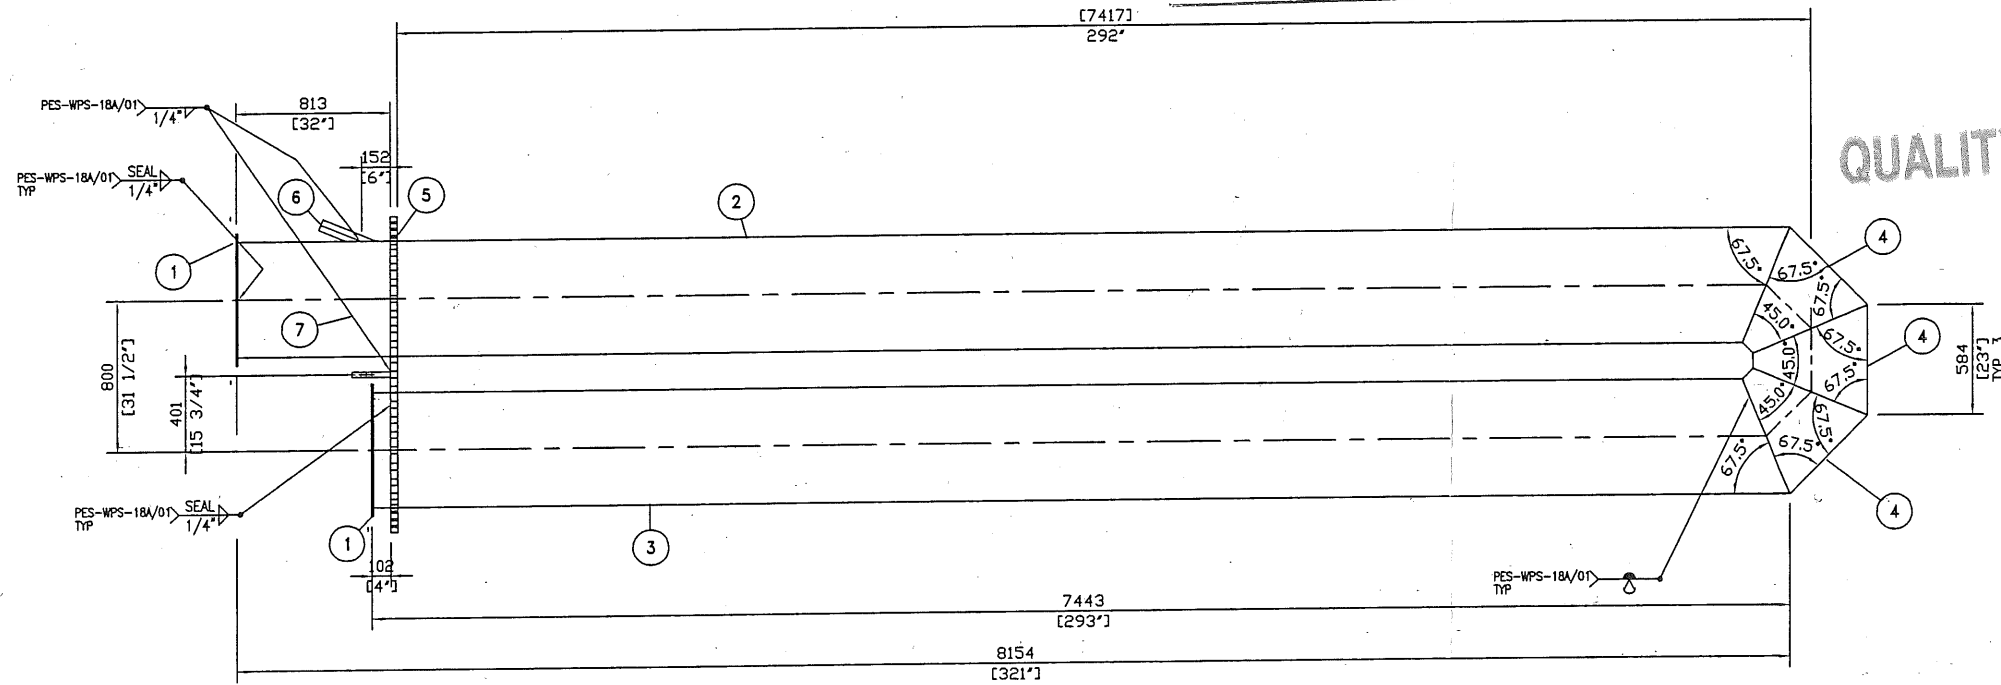

FIRETUBE TOP VIEW DETAIL

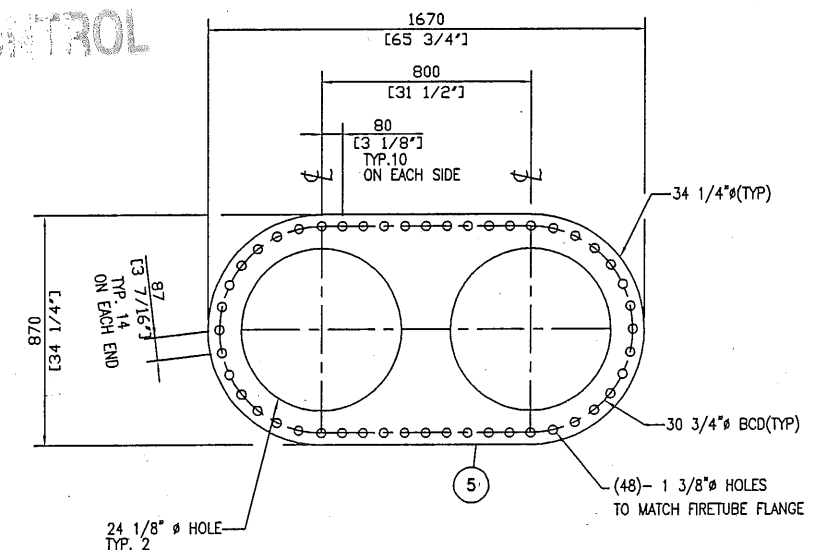

FIRETUBE COVER DETAIL

| BILL OF MATERIAL |       |                                                                                       |            |         |
|------------------|-------|---------------------------------------------------------------------------------------|------------|---------|
| ITEM             | REQ'D | DESCRIPTION                                                                           | QTY        | REMARKS |
| 1                | 3     | BURNER/STACK FLANGE, 3/8" THK PLATE X 23 3/4" ID X 27 1/2" OD                         | SA-36      |         |
| 2                | 1     | FIRETUBE PIPE, 24" SCH XH (0.5" THK) X 321 3/4" LG                                    | SA-106-B   |         |
| 3                | 1     | FIRETUBE PIPE, 24" SCH XH (0.5" THK) X 293 3/4" LG                                    | SA-106-B   |         |
| 4                | 3     | FIRETUBE PIPE, 24" SCH XH (0.5" THK) ERW X 23" LG                                     | SA-106-B   |         |
| 5                | 1     | FIRETUBE COVER, 1 1/2" THK X 34 1/4" W X 65 1/4" LG                                   | SA-516-70W |         |
| 6                | 1     | IGNITER ACCESS PIPE, 2" SCH XH SMLS X 12" LG (MOE X TOE)                              | SA-106-B   |         |
| 7                | 1     | FIRETUBE LIFT LUG, 1 1/8" THK PLATE X 6" W X 8" LG                                    | SA-36      |         |
| 8                | 6     | FIRETUBE SUPPORT, C6 X 8.2 X 92 3/16" LG (CTS)                                        | SA-36      |         |
| 9                | 2     | STACK/ARRESTOR GASKETS, 1/8" THK NON-ASBESTOS CUT GASKET, DURLON 8500 OR CARLOCK 3200 | -          |         |
| 10               | 24    | MACHINE BOLT FOR STACKS, 1/2" X 1 1/2" LG C/W 1 HEX HD NUT                            | GR 5       |         |
| 11               | 24    | MACHINE BOLT FOR ARRESTORS, 1/2" X 2 1/2" LG C/W 1 HEX HD NUT                         | GR 5       |         |

NOTES:

| REV    | DESCRIPTION                                       | BY | DATE     | CHK'D | APP'D |
|--------|---------------------------------------------------|----|----------|-------|-------|
| 3      | REVISED AS NOTED                                  | LL | 17-10-31 | BX    | DG    |
| 2      | REMOVED "HOLD" STATUS & REVISED AS NOTED          | LL | 17-08-15 | BX    | DG    |
| 1      | ADDED BOLTS FOR STACK/ARRESTOR                    | LL | 16-05-04 | BX    | DG    |
| 0      | ISSUED FOR CONSTRUCTION                           | LL | 16-02-24 | BX    | DG    |
| VES-01 | 96" OD X 30'-0" S/S 75PSI MAMP SWEET SERVICE FWKO | LL | 16-01-22 | BX    | BD    |

ENGINEER'S STAMP


|          |                  |                |
|----------|------------------|----------------|
| DRAWN BY | LL               | 16-01-22       |
| CHK'D BY | BX               | 16-01-22       |
| APP'D BY | DG               | 16-01-22       |
| CAD REF  | 30138-VES-03.DWG | SCALE AS SHOWN |

**PLATINUM**  
ENERGY SERVICES ULC  
A Trillium Industries Canada Company  
CALGARY, ALBERTA


|             |                                                                      |
|-------------|----------------------------------------------------------------------|
| CLIENT      | STOCK                                                                |
| TITLE       | 96" OD X 30'-0" S/S 75PSI MAMP SWEET SERVICE FWKO<br>FIRETUBE DETAIL |
| JOB NO.     | 30138                                                                |
| DRAWING NO. | 30138-VES-03                                                         |
| REV         | 3                                                                    |

S:\TRANSFERS\UNIT NUMBERS\30000\30138\30138-VES-01.DWG


The information contained in this drawing is the confidential property of Palladium Energy Services ULC. No part thereof shall be reproduced or communicated to a third party without written authorization from Palladium Energy Services ULC.

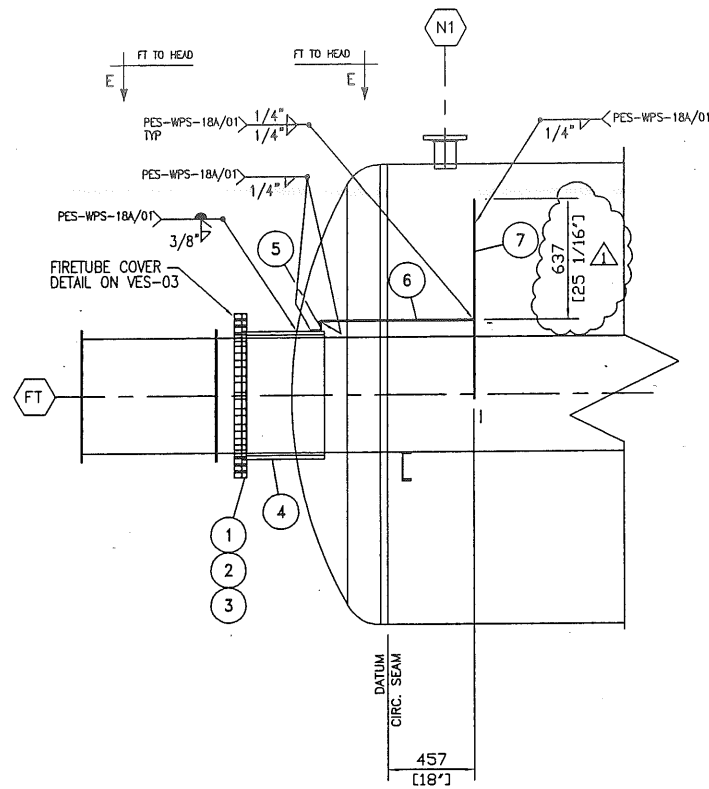


FIRETUBE NECK & INLET DEFLECTOR ASSY. ELEVATION VIEW

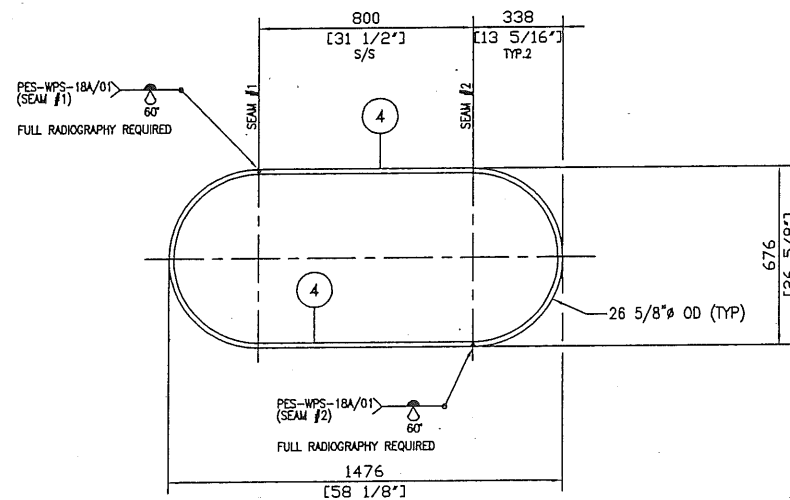

FIRETUBE NECK DETAIL

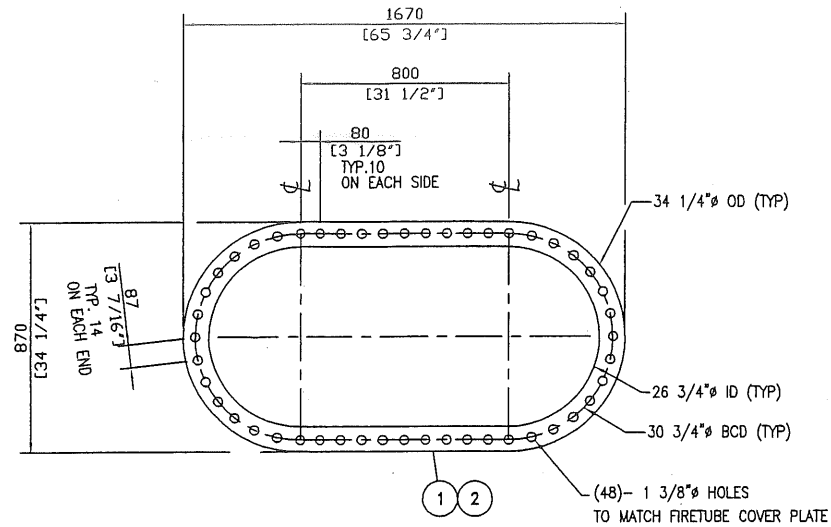


FIRETUBE FLANGE & GASKET DETAIL

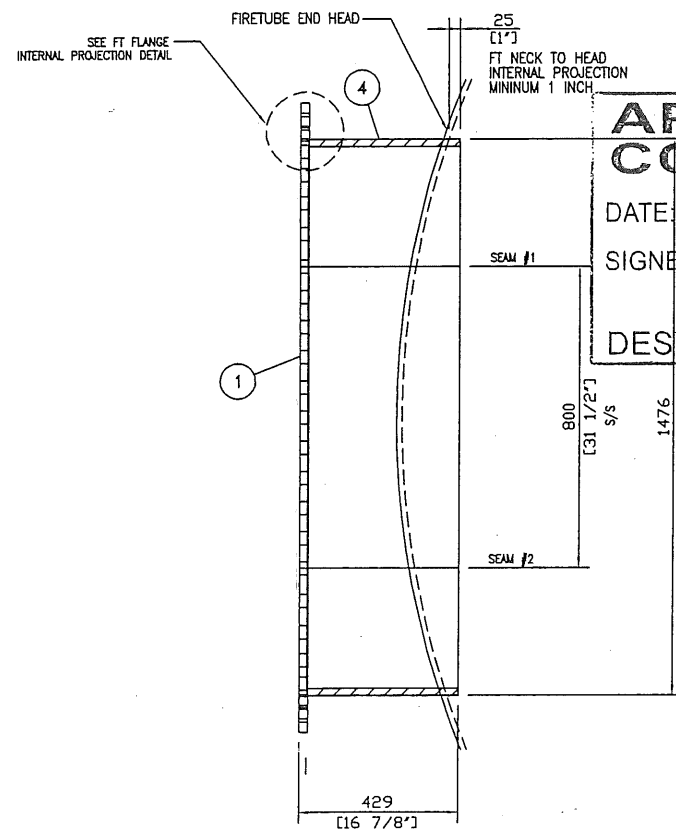


ITEM #1 & #4 ASSY. DETAIL TOP VIEW 'E-E'

| BILL OF MATERIAL |       |                                                                                       |               |
|------------------|-------|---------------------------------------------------------------------------------------|---------------|
| ITEM             | REQ'D |                                                                                       |               |
| 1                | 2     | FIRETUBE FLANGE, 1" THK PLATE X 34 1/4" W X 65 3/4" LG                                | SA-516-70N    |
| 2                | 1     | 1/8" THK NON-ASBESTOS CUT GASKET, DURLON 8500 OR CARLOCK 3200, AGS PART #JWFTGSKT8-10 |               |
| 3                | 48    | STUDS, 1 1/4" Ø X 8" LG, C/W 2 NUTS EA                                                | 193-B7/194-2H |
| 4                | 2     | FIRETUBE NECK, 3/4" THK PLATE X 16" W X 44 13/16" LG( SEE DETAIL)                     | SA-516-70N    |
| 5                | 1     | L2 X 2 X 1/4 X 28" LG                                                                 | SA-36         |
| 6                | 1     | INLET DEFLECTOR PLATE, 1/4" THK X 32" W X 58" LG                                      | SA-36         |
| 7                | 1     | BAFFLE PLATE, 1/4" THK X 95 1/8" OD CUT PER DETAIL                                    | SA-36         |

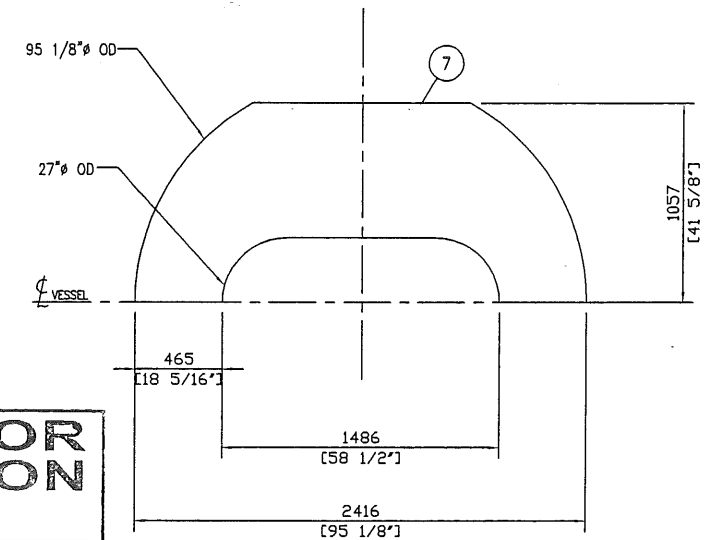

BAFFLE PLATE DETAIL

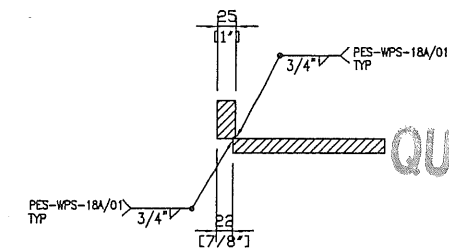

FT FLANGE INTERNAL PROJECTION DETAIL

**APPROVED FOR CONSTRUCTION**  
DATE: AUG 15 2017  
SIGNED:   
**REVISED**  
DESTROY ALL PREVIOUS COPIES

**QUALITY CONTROL**

NOTES:

| REV | DESCRIPTION             | BY | DATE     | CHK'D | APP'D |
|-----|-------------------------|----|----------|-------|-------|
| 1   | REVISED AS NOTED        | LL | 17-08-15 | BX    | DG    |
| 0   | ISSUED FOR CONSTRUCTION | LL | 16-02-24 | BX    | DG    |
| 0   | ISSUED FOR APPROVAL     | LL | 16-01-29 | BX    | BD    |

ENGINEER'S STAMP

|          |                  |                |
|----------|------------------|----------------|
| DRAWN BY | LL               | 16-01-29       |
| CHK'D BY | BX               | 16-01-29       |
| APP'D BY | DG               | 16-01-29       |
| CAD REF  | 30138-VES-04.DWG | SCALE AS SHOWN |

CLIENT

STOCK


TITLE  
96" OD X 30'-0" S/S 75PSI MAWP SWEET SERVICE EMULSION TREATER  
FIRETUBE NECK & INLET DEFLECTOR AND BAFFLE PLATE DETAIL

|         |       |             |              |     |   |
|---------|-------|-------------|--------------|-----|---|
| JOB NO. | 30138 | DRAWING NO. | 30138-VES-04 | REV | 1 |
|---------|-------|-------------|--------------|-----|---|


CALGARY, ALBERTA

S:\TRANSFERS\UNIT NUMBER\30000\30138\30138-VES-01.DWG

The information contained in this drawing is the confidential property of Platinum Energy Services ULC. No part thereof shall be reproduced or communicated to a third party without written authorization from Platinum Energy Services ULC.

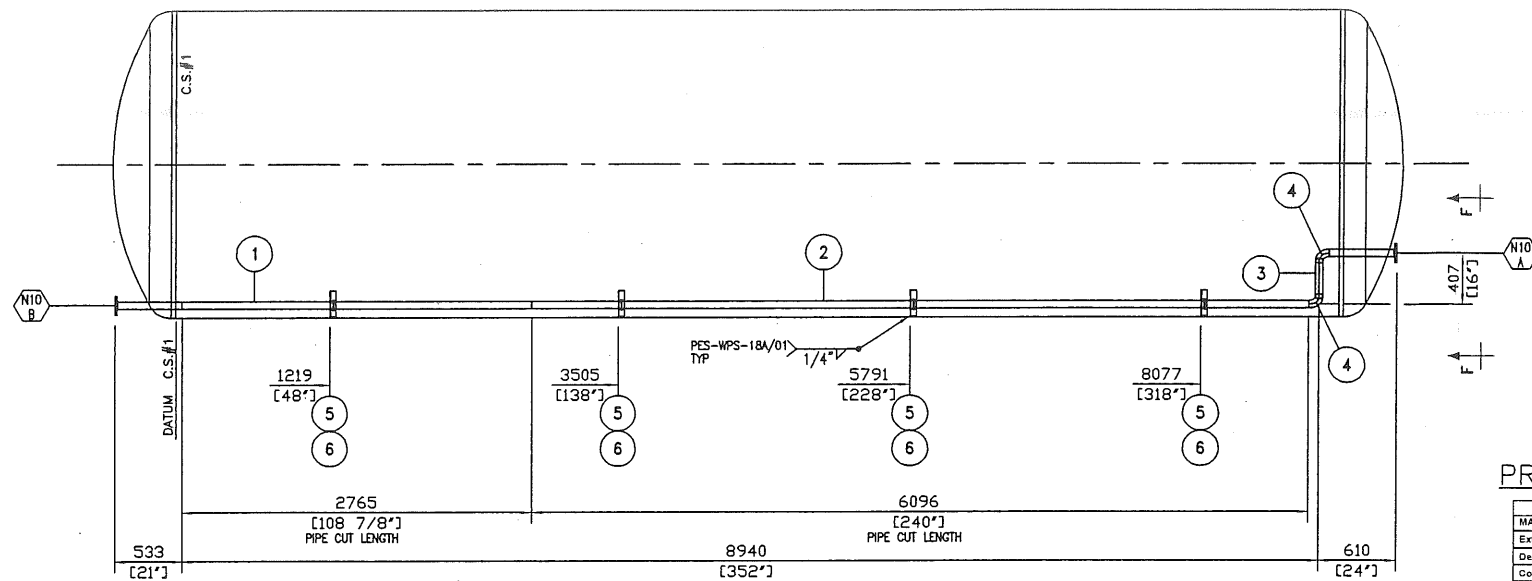

PREHEAT PIPE ELEVATION VIEW

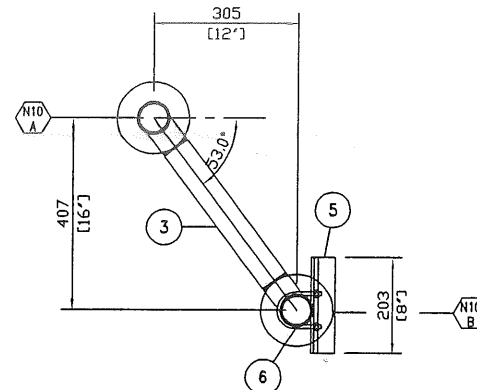


PREHEAT PIPE VIEW 'F-F'


PREHEAT PIPE DESIGN DATA

| PREHEAT PIPE            |                                     |
|-------------------------|-------------------------------------|
| MAWP Press.             | 75 Psig (517 kPag)                  |
| External Press.         | 75 Psig (517 kPag)                  |
| Design Temp.            | 350°F (177°C)                       |
| Corrosion All.          | 0.0625" (1.6 mm)                    |
| Test Press.             | 98 Psig (678 kPag)                  |
| X-Ray                   | NONE                                |
| Min. Metal Design Temp. | -20°F • 75 Psig<br>-29°C • 517 kPag |


1 BUTT WELD

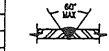


PES-WPS-01  
PES-WPS-03

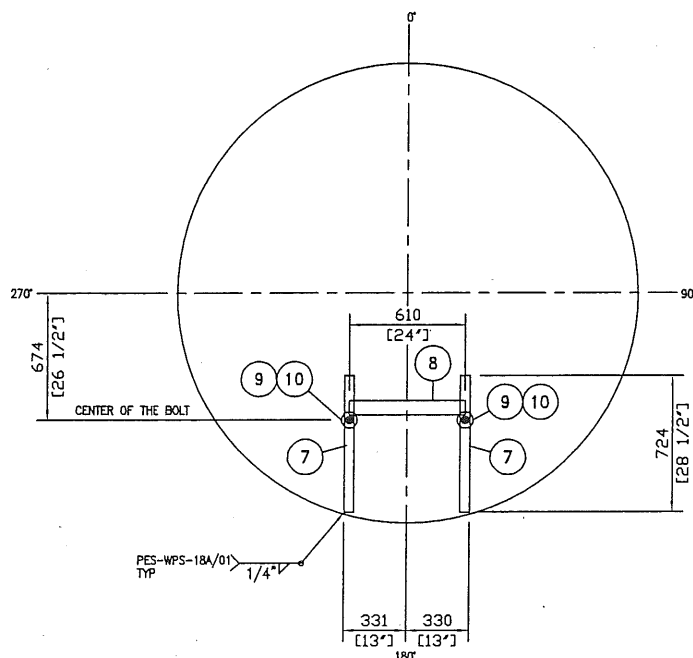

ANODE SUPPORT ASSY. DETAIL

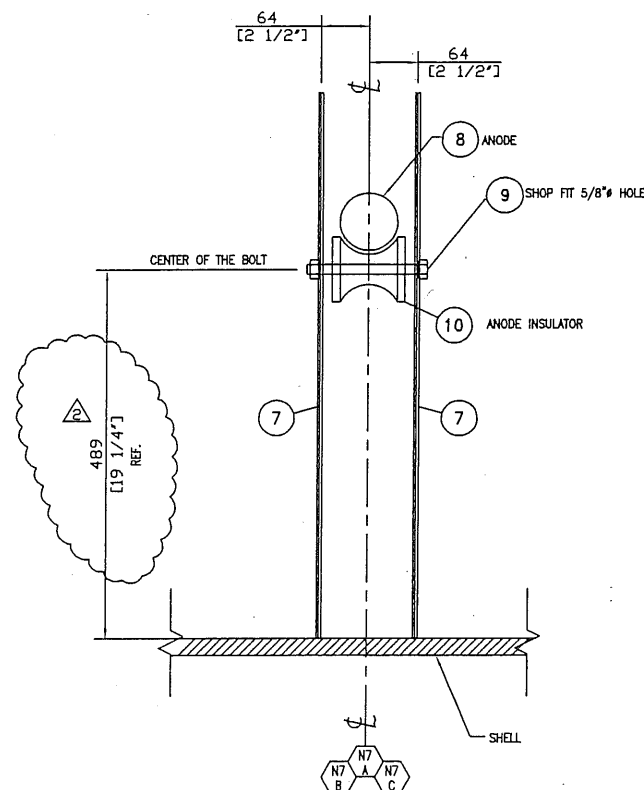

ANODE SUPPORT BRACKETS DETAIL  
(3 REQUIRED FOR NOZZLE N7A-C)

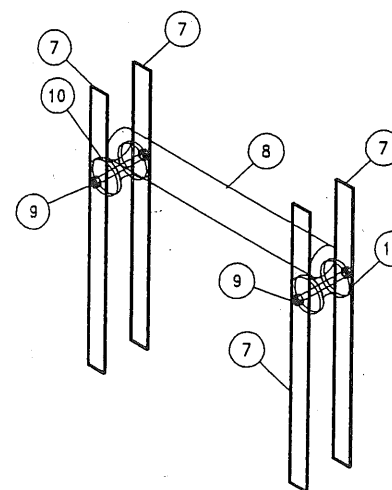

ANODE SUPPORT SW ISOMETRIC VIEW

PREHEAT PIPE ISOMETRIC VIEW

QUALITY CONTROL


APPROVED FOR CONSTRUCTION

DATE: AUG 15 2017


SIGNED: [Signature]

REVISED  
DESTROY ALL PREVIOUS COPIES

| BILL OF MATERIAL |       |                                                                          |            |
|------------------|-------|--------------------------------------------------------------------------|------------|
| ITEM             | REQ'D |                                                                          |            |
| 1                | 1     | PIPE, 2" SCH 160 SMLS X 108 7/8" LG (CTS)                                | SA-106-B   |
| 2                | 1     | PIPE, 2" SCH 160 SMLS X 240" LG (CTS)                                    | SA-106-B   |
| 3                | 1     | PIPE, 2" SCH 160 SMLS X 13 3/4" LG (CTS)                                 | SA-106-B   |
| 4                | 2     | WELD ELBOW, 2" SCH 160, 90° LR BW                                        | SA-234-WPB |
| 5                | 4     | PREHEAT SUPPORT, L2 X 2 X 1/4 X 8" LG                                    | SA-36      |
| 6                | 4     | 2" U-BOLT, C/W 2 NUTS EA                                                 | GR.5       |
| 7                | 12    | ANODE SUPPORT, FLAT BAR, 1/4" THK X 2" X 28 1/2" LG(CTS)                 | SA-36      |
| 8                | 3     | ALUMINUM SACRIFICIAL ANODE 3" X 24"                                      | SA-106-B   |
| 9                | 6     | 1/2" Ø X 5 1/2" LG SST BOLT C/W NUT, FLAT + LOCK WASHER                  | SST        |
| 10               | 6     | WOODEN ANODE INSULATOR                                                   | -          |
| 11               | 1     | BIRDS SCREEN, EXPANDED METAL, 13GA X 3/4" X 33 7/8" OD (BEND PER DETAIL) | C.S.       |
| 12               | 1     | PIPE, 24" SCH 10 (0.25" WT) ERW X 16'-0" LG                              | SA-53B     |
| 13               | 1     | PIPE, 24" SCH 10 (0.25" WT) ERW X 2'-2" LG                               | SA-53B     |

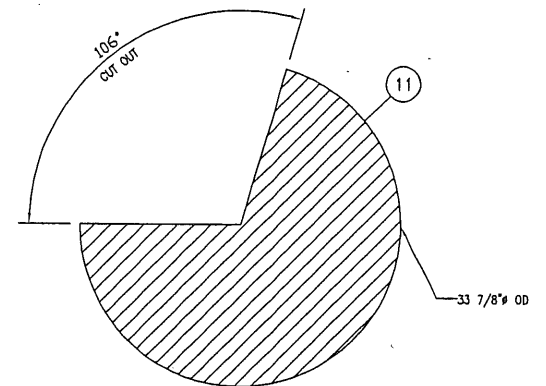

ITEM #11 DETAIL

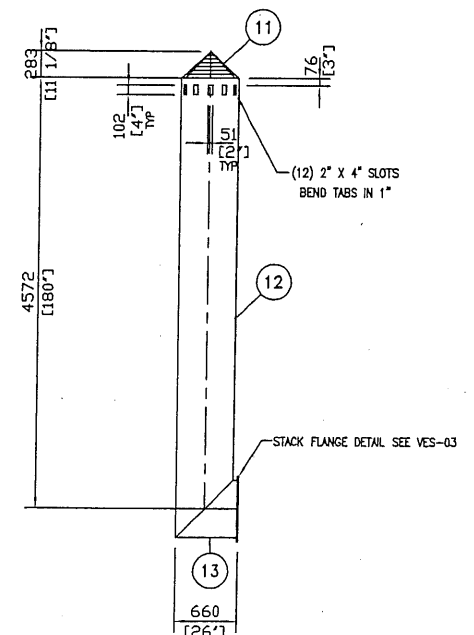

STACK DETAIL

NOTES:  
1. APPLY HIGH TEMP. LUBRICANTS ON ALL INTERNAL STUDS/BOLTS/NUTS.  
2. FILLET WELD SIZE TO BE 1/4" UNLESS NOTED OTHERWISE.

| REV                | DESCRIPTION                                                 | BY | DATE     | CHK'D | APP'D |
|--------------------|-------------------------------------------------------------|----|----------|-------|-------|
| 2                  | REVISED AS NOTED                                            | LL | 17-08-15 | BX    | DG    |
| 1                  | ADDED PREHEAT PIPE DESIGN DATA & REVISED AS NOTED           | LL | 16-03-16 | BX    | DG    |
| 0                  | ISSUED FOR CONSTRUCTION                                     | LL | 16-02-24 | BX    | DG    |
| A                  | ISSUED FOR APPROVAL                                         | LL | 16-01-28 | BX    | BD    |
| VES-01             | 96" OD X 30'-0" S/S 75PSI MAMP SWEET SERVICE EMULSION TREAT |    |          |       |       |
| REFERENCE DRAWINGS |                                                             |    |          |       |       |

ENGINEER'S STAMP

|          |                  |                |
|----------|------------------|----------------|
| DRAWN BY | LL               | 16-01-28       |
| CHK'D BY | BX               | 16-01-28       |
| APP'D BY | DG               | 16-01-28       |
| CAD REF  | 30138-VES-05.DWG | SCALE AS SHOWN |

CLIENT

STOCK


TITLE  
96" OD X 30'-0" S/S 75PSI MAMP SWEET SERVICE EMULSION TREAT  
PREHEAT PIPING, ANODE SUPPORT ASSY. & STACK DETAIL

JOB NO. 30138 DRAWING NO. 30138-VES-05 REV 2


CALGARY, ALBERTA

S:\TRANSFERS\UNIT NUMBER\30000\30138\30138-VES-01.DWG


The information contained in this drawing is the confidential property of Platinum Energy Services ULC. No part thereof shall be reproduced or communicated to a third party without written authorization from Platinum Energy Services ULC.

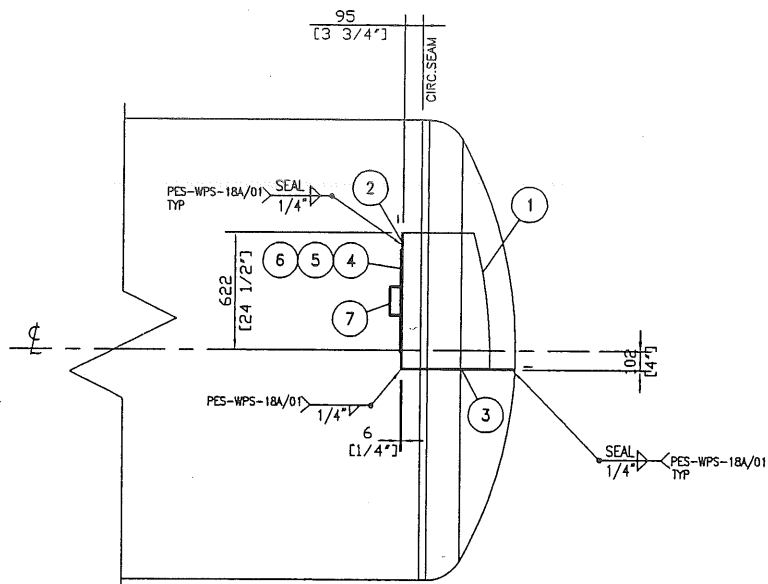


OIL BOX ELEVATION VIEW

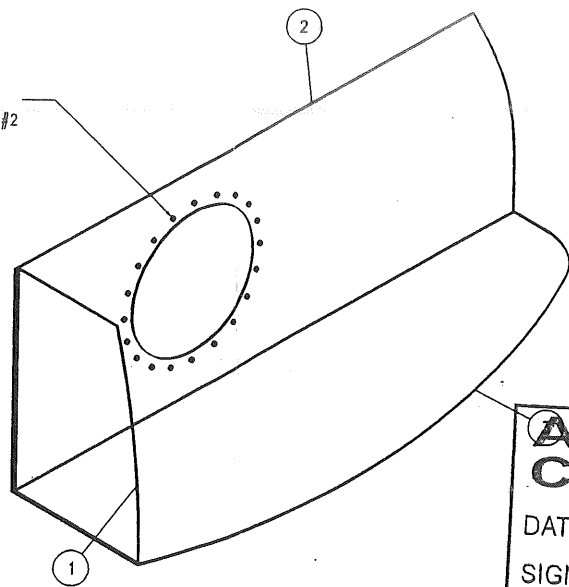


OIL BOX SE ISOMETRIC VIEW

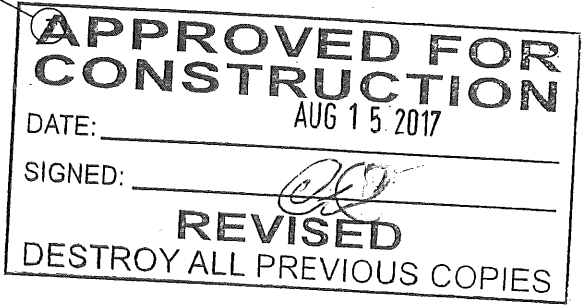


| BILL OF MATERIAL |       |                                                                                       |       |
|------------------|-------|---------------------------------------------------------------------------------------|-------|
| ITEM             | REQ'D |                                                                                       |       |
| 1                | 1     | OIL BOX SIDE PLATE, 1/4" THK X 18 1/16" W X 28 1/2" LG                                | SA-36 |
| 2                | 1     | OIL BOX BUCKET PLATE, 1/4" THK X 22 7/8" W X 73 1/4" LG                               | SA-36 |
| 1                | 1     | OIL WEIR PLATE, 1/4" THK X 28 1/2" W X 73 1/4" LG                                     | SA-36 |
| 4                | 1     | OIL BOX ACCESS PLATE, 1/4" THK X 21 1/2" OD                                           | SA-36 |
| 5                | 1     | 1/8" THK NON-ASBESTOS CUT GASKET, 21 1/2" OD X 17 3/4" ID BURLON 8500 OR GARLOCK 3200 | -     |
| 6                | 20    | BOLTS, 1/2" Ø X 1 1/2" LG, C/W 2 NUTS EA                                              | SST   |
| 7                | 1     | ACCESS HANDLES, ROUND BAR, 3/8" OD X 10" LG (BENT PER DETAIL)                         | SA-36 |
|                  |       |                                                                                       |       |
|                  |       |                                                                                       |       |
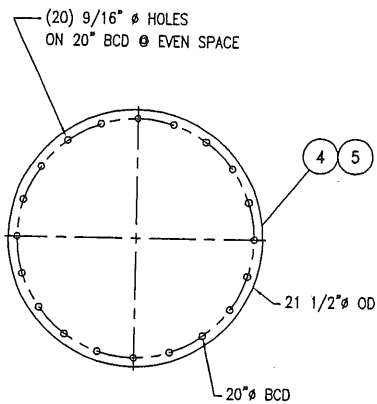


ITEM #4 & #5 DETAIL

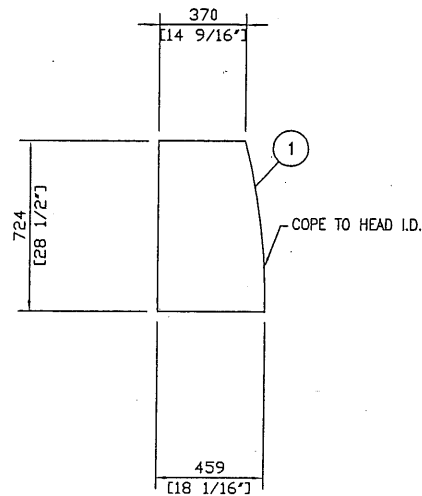


ITEM #1 DETAIL

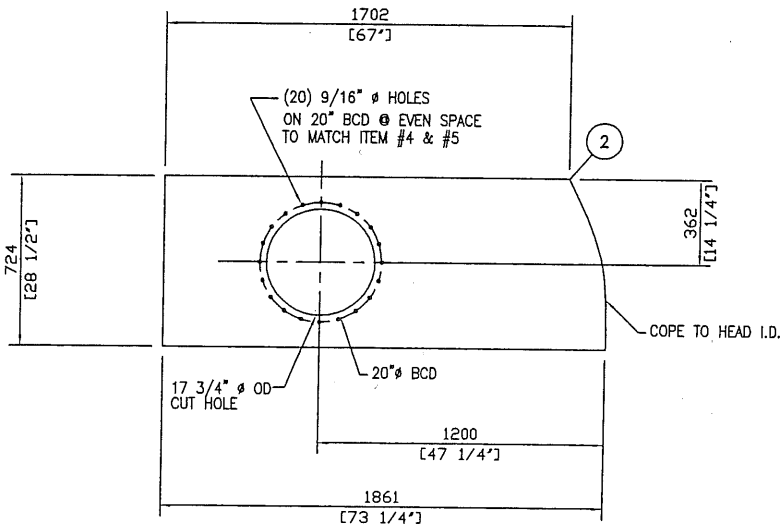

ITEM #2 DETAIL

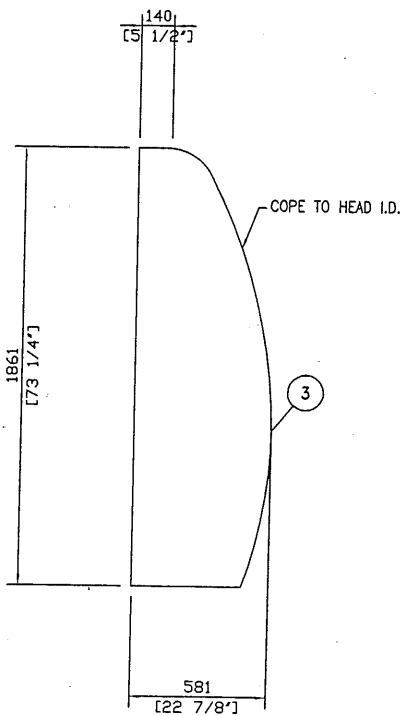


ITEM #3 DETAIL

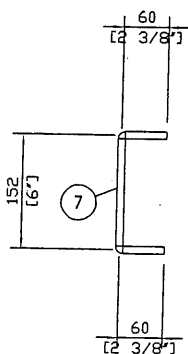

ITEM #7 DETAIL

## QUALITY CONTROL

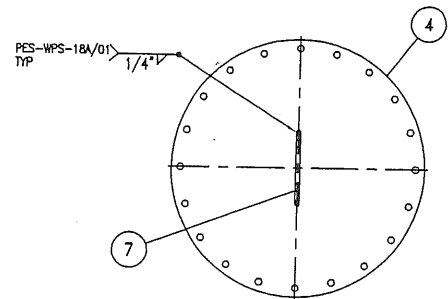

HANDLE ASSY. DETAIL


- NOTES:
1. ALL BOLTS FOR REMOVABLE PANEL TO BE TACK WELDED ON UNMOVABLE PLATES.
  2. APPLY HIGH TEMP. LUBRICANTS ON ALL INTERNAL STUDS/BOLTS/NUTS.
  3. FILLET WELD SIZE TO BE 1/4" UNLESS NOTED OTHERWISE.

| REV                | DESCRIPTION             | BY | DATE     | CHK'D | APP'D |
|--------------------|-------------------------|----|----------|-------|-------|
| 1                  | REVISED AS NOTED        | LL | 17-08-15 | BX    | DG    |
| 0                  | ISSUED FOR CONSTRUCTION | LL | 16-02-24 | BX    | DG    |
| A                  | ISSUED FOR APPROVAL     | LL | 16-01-28 | BX    | BD    |
| REFERENCE DRAWINGS |                         |    |          |       |       |


|                                                       |  |                             |  |              |                                                                                       |                               |
|-------------------------------------------------------|--|-----------------------------|--|--------------|---------------------------------------------------------------------------------------|-------------------------------|
| ENGINEER'S STAMP                                      |  | DRAWN BY<br>LL<br>16-01-22  |  | <div>△</div> | CLIENT                                                                                | <div>STOCK</div> <div>△</div> |
|                                                       |  | CHK'D BY<br>BX<br>16-01-22  |  |              |                                                                                       |                               |
|                                                       |  | APP'D BY<br>DG<br>16-01-22  |  |              |                                                                                       |                               |
|                                                       |  | CAD REF<br>30138-VES-06.DWG |  |              |                                                                                       |                               |
|                                                       |  | SCALE<br>AS SHOWN           |  |              |                                                                                       |                               |
|                                                       |  |                             |  |              | TITLE<br>96" OD X 30'-0" S/S 75PSI MAWP SWEET SERVICE EMULSION TREATER OIL BOX DETAIL |                               |
|                                                       |  |                             |  |              |                                                                                       |                               |
| S:\TRANSFERS\UNIT NUMBER\30000\30138\30138-VES-01.DWG |  | CALGARY, ALBERTA            |  |              | JOB NO.<br>30138                                                                      | DRAWING NO.<br>30138-VES-06   |
|                                                       |  |                             |  |              | REV<br>1                                                                              |                               |

S:\TRANSFERS\UNIT NUMBERS\30000\30138\30138-VES-01.DWG




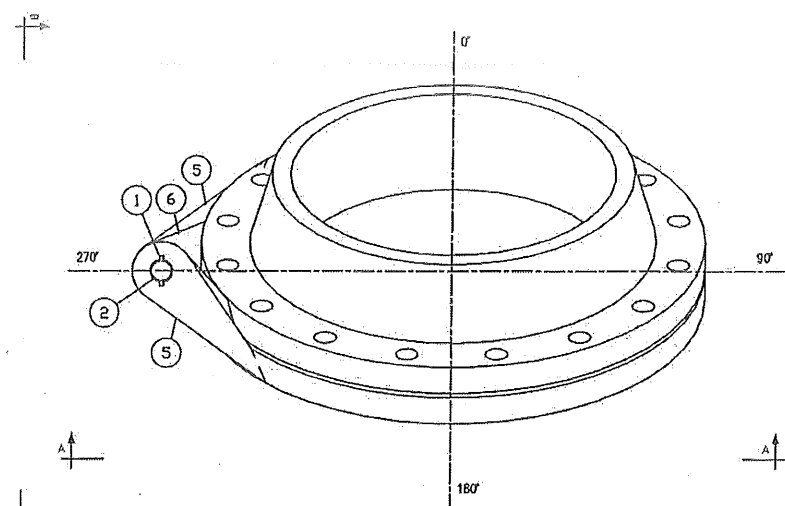


MANWAY ATTACHMENTS TOP VIEW  
SCALE: 1:4

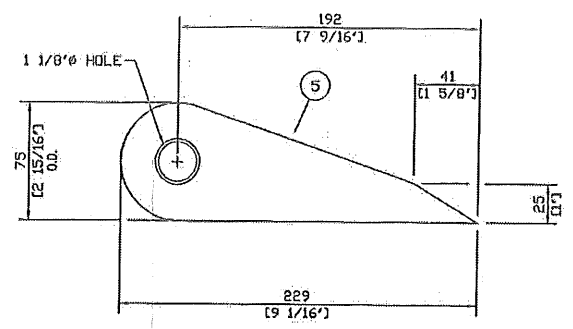


HINGE ITEM #5 DETAIL  
SCALE: 1:2

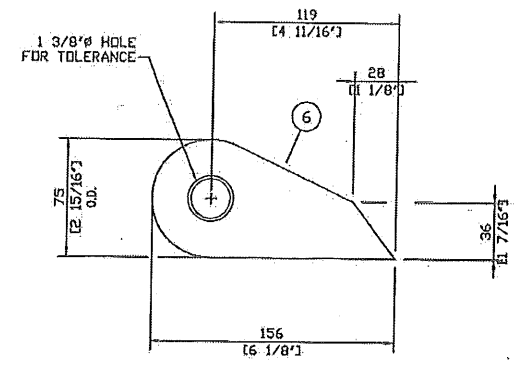

HINGE ITEM #6 DETAIL  
SCALE: 1:2

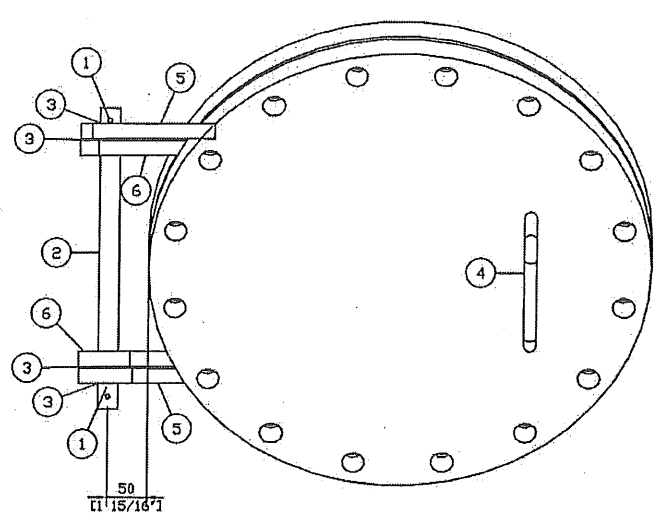


'A-A' VIEW  
SCALE: 1:4

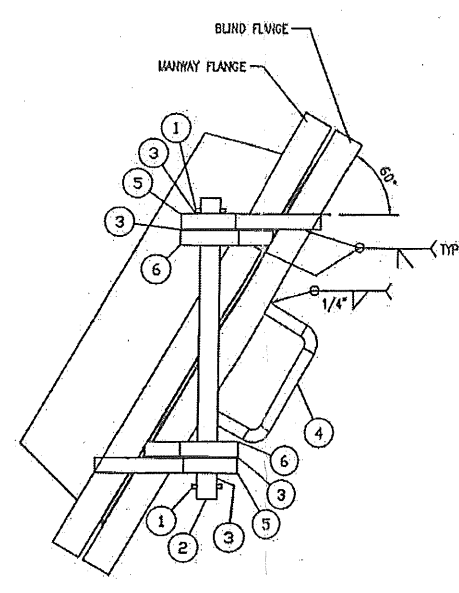

'B-B' VIEW  
SCALE: 1:4

QUALITY CONTROL

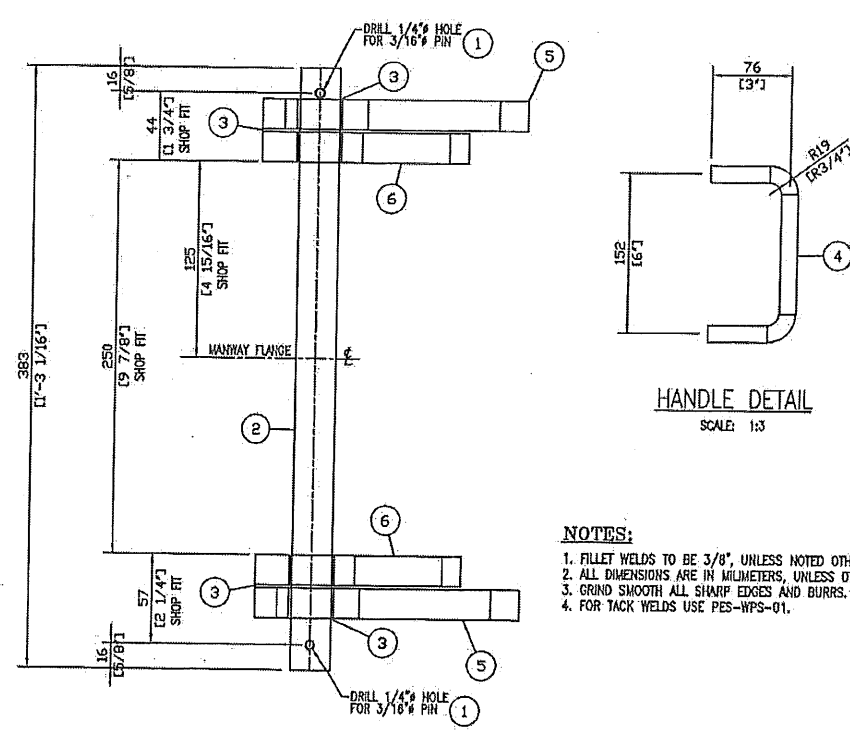

MANWAY ATTACHMENTS DETAIL  
SCALE: 1:2

- NOTES:
1. FILLET WELDS TO BE 3/8", UNLESS NOTED OTHERWISE.
  2. ALL DIMENSIONS ARE IN MILLIMETERS, UNLESS OTHERWISE NOTED.
  3. GRIND SMOOTH ALL SHARP EDGES AND BURRS.
  4. FOR TACK WELDS USE PES-WPS-01.

| BILL OF MATERIAL |       |                                                     |            |
|------------------|-------|-----------------------------------------------------|------------|
| ITEM             | REQ'D | DESCRIPTION                                         | MAT'L      |
| 1                | 2     | COTTER PIN, 3/16" x 1 1/2" LG                       | 304L SS    |
| 2                | 1     | ROUND BAR, 1" x 1'-3 1/16" LG                       | SA-36/44W  |
| 3                | 4     | FLAT WASHER 1"                                      | STEEL      |
| 4                | 1     | HANDLE, 3/4" ROUND BAR x 12" LG CTS/BEND PER DETAIL | SA-36/44W  |
| 5                | 2     | PLATE, 3/4" x 9 1/16" x 2 15/16" CTS                | SA-516-70N |
| 6                | 2     | PLATE, 3/4" x 8 1/8" x 2 15/16" CTS                 | SA-516-70N |

**APPROVED FOR CONSTRUCTION**

DATE: FEB 24 2016



SIGNED:

| REFERENCE DRAWINGS | REV | DESCRIPTION             | BY | DATE     | CHK'D | APP'D |
|--------------------|-----|-------------------------|----|----------|-------|-------|
|                    | 0   | ISSUED FOR CONSTRUCTION | LL | 18-02-12 | DX    | DG    |




|                  |  |                               |                 |                                                                       |
|------------------|--|-------------------------------|-----------------|-----------------------------------------------------------------------|
| ENGINEER'S STAMP |  | DRAWN BY: LL                  | 18-01-28        | CLIENT: STANDARDS                                                     |
|                  |  | CHK'D BY: BX                  | 18-01-28        |                                                                       |
|                  |  | APP'D BY: DG                  | 18-01-28        |                                                                       |
|                  |  | CAD REF: 18-150-30 DEGREE.DWG | SCALE: AS SHOWN |                                                                       |
|                  |  |                               |                 | TITLE: 18" 150# MANWAY 30 DEGREE ATTACHMENTS RIGHT HAND OPEN (FOR M2) |
|                  |  | CALGARY, ALBERTA              |                 | JOB NO: 30138<br>DRAWING NO: 18-150-30 DEGREE<br>REV: 0               |

The information contained in this drawing is the confidential property of Platinum Energy Services Corp. Its use without written authorization from Platinum Energy Services Corp. is prohibited.



The information contained in this drawing is the confidential property of Platinum Energy Services Corp. No part thereof shall be reproduced or communicated to a third party without written authorization from Platinum Energy Services Corp.

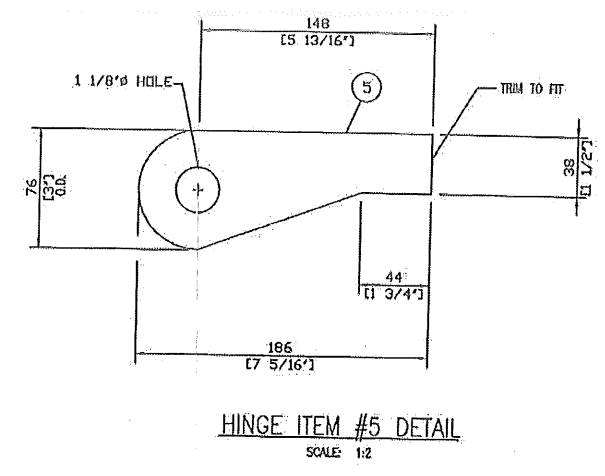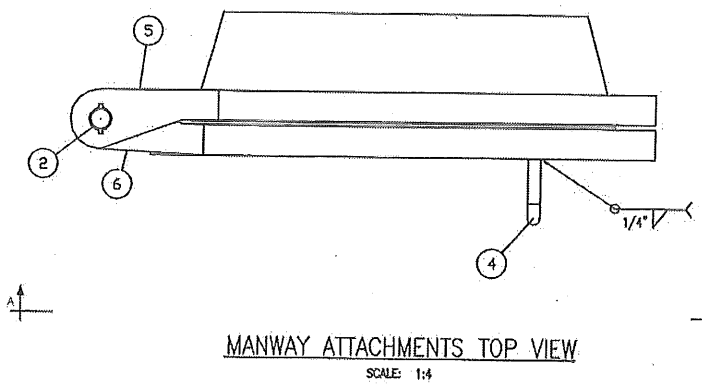

| BILL OF MATERIAL |       |                                           |            |
|------------------|-------|-------------------------------------------|------------|
| ITEM             | REQ'D | DESCRIPTION                               | MAT'L      |
| 1                | 2     | COTTER PIN, 3/16" x 1 1/2" LG             | 304L SS    |
| 2                | 1     | ROUND BAR, 1" x 1'-7 9/16" LG             | SA-36/44W  |
| 3                | 4     | FLAT WASHER 1"                            | STEEL      |
| 4                | 1     | HANDLE, 3/4" x 12" LG CTS/BEND PER DETAIL | SA-36/44W  |
| 5                | 2     | PLATE, 3/4" x 7 5/16" x 3" CTS            | SA-516-70N |
| 6                | 2     | PLATE, 3/4" x 6 11/16" x 3" CTS           | SA-516-70N |

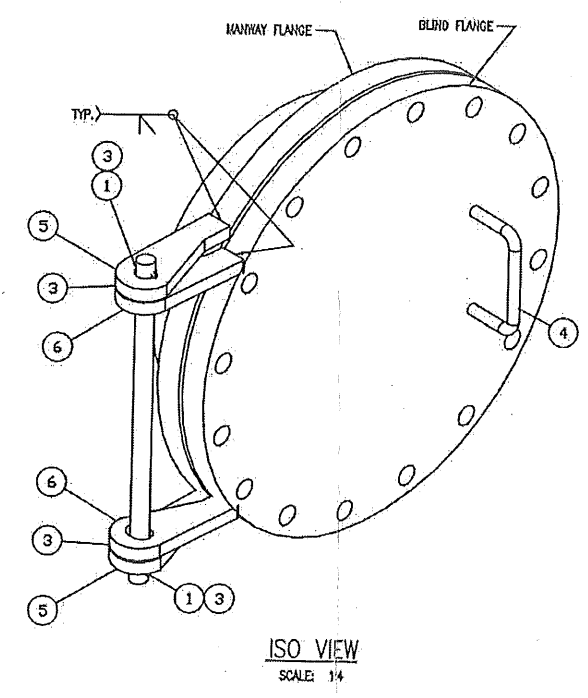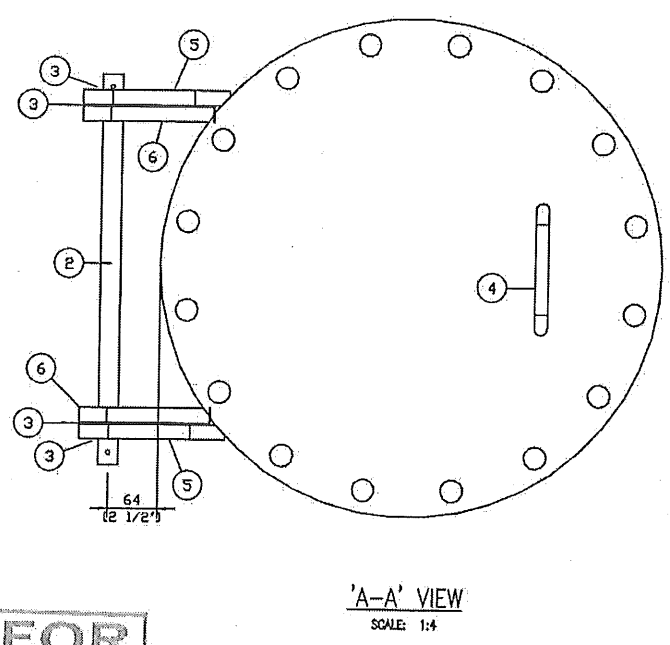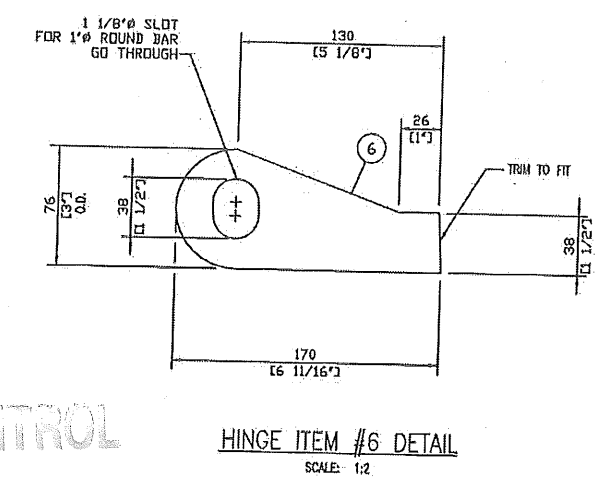

QUALITY CONTROL

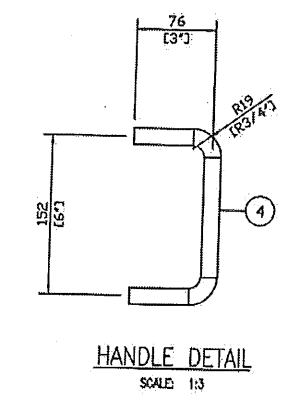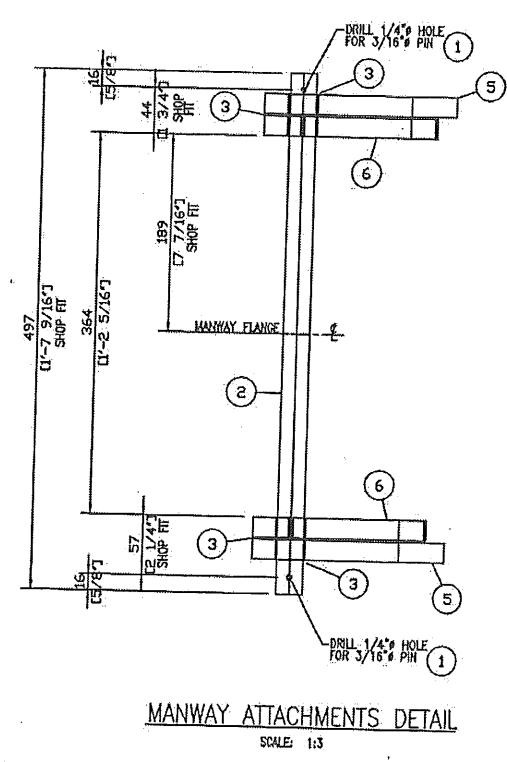

- NOTES:
1. FILLET WELDS TO BE 3/8", UNLESS NOTED OTHERWISE.
  2. ALL DIMENSIONS ARE IN MILLIMETERS, UNLESS OTHERWISE NOTED.
  3. GRIND SMOOTH ALL SHARP EDGES AND BURRS.
  4. FOR TACK WELDS USE PES-WPS-01.

APPROVED FOR  
CONSTRUCTION

DATE: FEB 24 2016

SIGNED: [Signature]

| REV | DESCRIPTION             | BY | DATE     | CHK'D | APP'D |
|-----|-------------------------|----|----------|-------|-------|
| 0   | ISSUED FOR CONSTRUCTION | LL | 16-02-16 | DX    | DG    |

|                               |  |                                       |  |                              |  |
|-------------------------------|--|---------------------------------------|--|------------------------------|--|
| ENGINEER'S STAMP              |  | DRAWN BY LL 16-02-16                  |  | CLIENT                       |  |
| CHK'D BY DX 16-02-16          |  | APP'D BY DO 16-02-16                  |  | STANDARDS                    |  |
| CAD REF 16-150-90 DEGREE DWG  |  | SCALE AS SHOWN                        |  | TITLE                        |  |
| PLATINUM ENERGY SERVICES LTD. |  | 18" 150# MANWAY 90 DEGREE ATTACHMENTS |  | RIGHT HAND OPEN (FOR M1)     |  |
| CALGARY, ALBERTA              |  | JOB NO. 30138                         |  | DRAWING NO. 18-150-90 DEGREE |  |
|                               |  |                                       |  | REV 0                        |  |