NOZZLE CHART

P&ID CONN. REF.	MK. #	SIZE	TYPE	RATING	PROJ.	DESCRIPTION
1	N1	219.1 (8")	RFWN	300#	1030	MUD INLET
4	N2	219.1 (8")	RFWN	300#	990	MUD OUTLET
13	N13	60.3 (2")	RFWN	150#	150	FLARE HEADER
4	N14	60.3 (2")	NPT	150#	140	MUD COOLER DRAIN
4	N16	114.3 (4")	RFWN	150#	155	SKID DRAIN
1	N17	114.3 (4")	RFWN	150#	–	VAC. TRUCK CONN.
1	N18	114.3 (4")	RFWN	150#	–	VAC. TRUCK CONN.

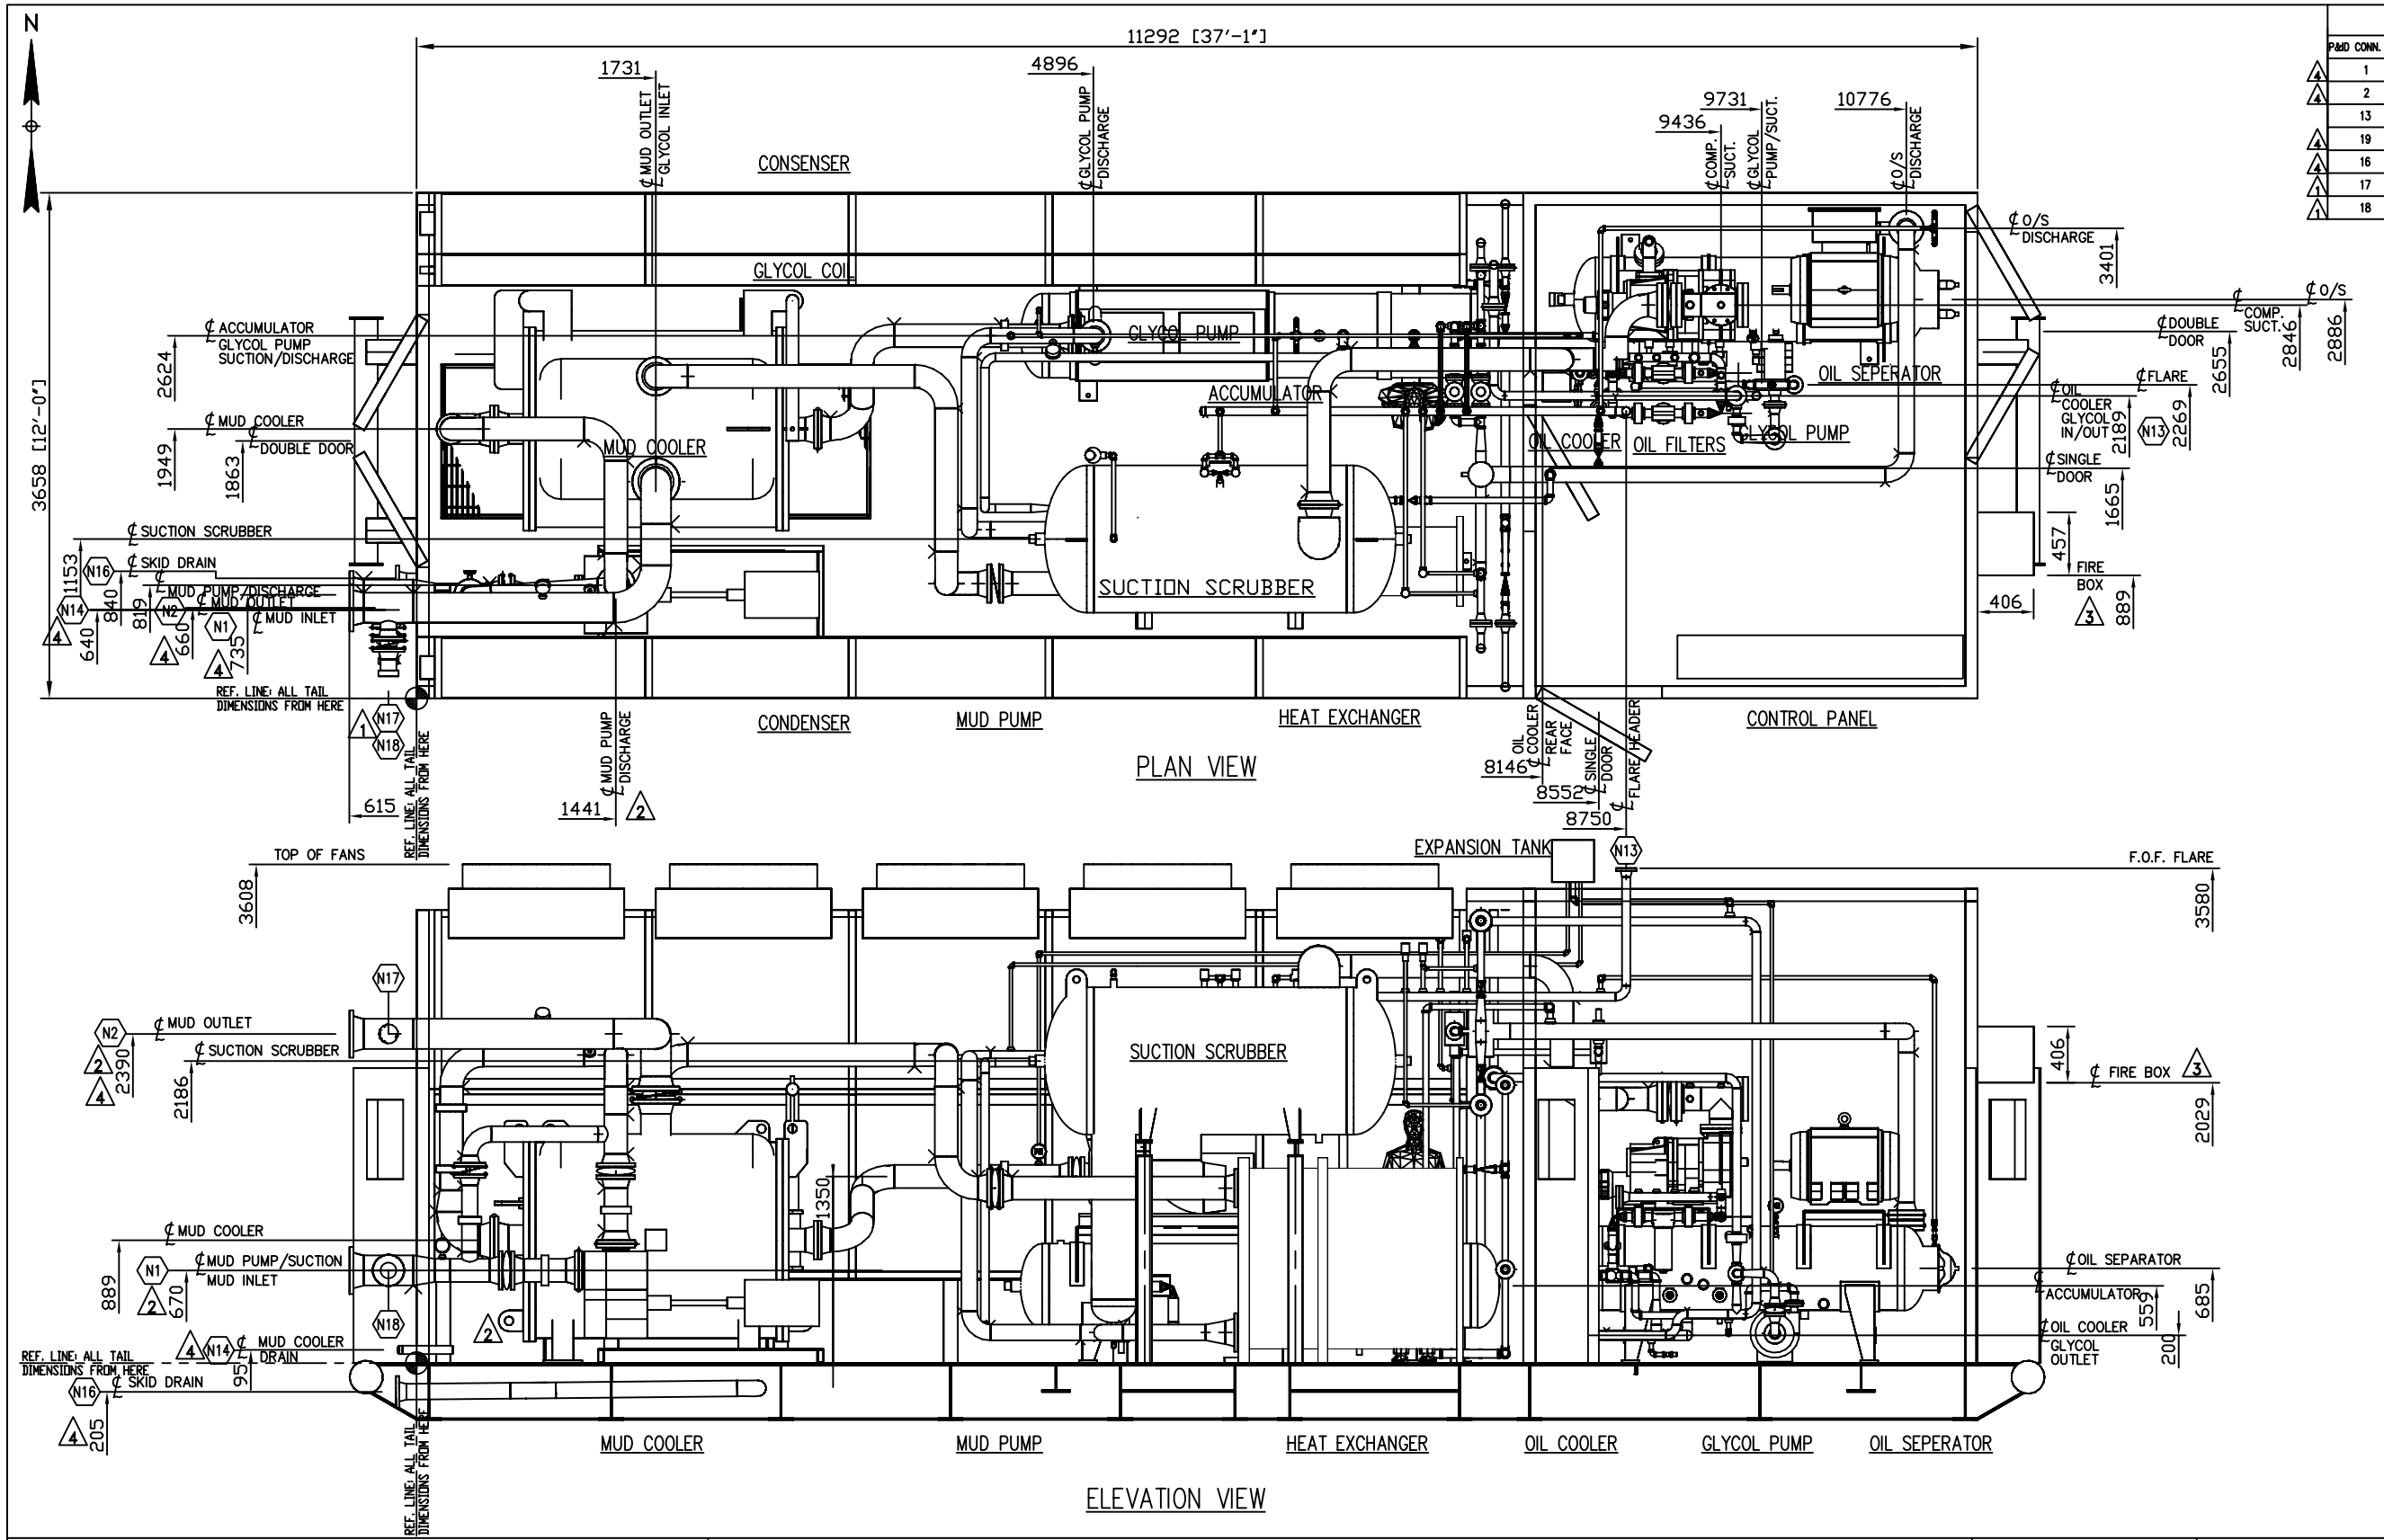

NOTES:

1. NO PIPE SUPPORTS IN FRONT OF MUD COOLER DOORS
2. DOUBLE DOOR PANIC BARS LOCATED ON THE SOUTH DOOR. CONFIRM LOCATION OF DOORS SO PANIC BARS DON'T INTERFERE WITH PIPE/VESSEL.

REFERENCE DRAWINGS

DWG. NO.	DESCRIPTION	DWG. NO.	DESCRIPTION
SRC0403-1	P & ID		

REVISIONS

NO.	DATE	BY	AP'D	DESCRIPTION
A	04/06/24	GWE		FOR APPROVAL
0	04/07/13	GWE		FOR CONSTRUCTION
1	04/10/27	BJB		AS-BUILT

SHIPPING WEIGHT

SANDBLAST

PRIMER

PAINT

DRAWN ACAD/STARTEC | DATE 04/03/19

CHECKED | DATE

ENG. APP'L. | DATE

PROD. APP'L. | DATE

JOB NO. SRC0403

Startec REFRIGERATION SERVICES LTD.

CUSTOMER RENTAL

TITLE MUD COOLER GENERAL ARRANGEMENT

SCALE NTS | DRAWING NO. SRC0403-2 | REV. 1